


- NOTES**
- 1) All temporary traffic management shall be in accordance with Chapter 8 of the Traffic Signs Manual 2009.
 - 2) All temporary traffic management shall be in accordance with the Traffic Signs Regulations and General Directions 2002.
 - 3) All temporary traffic management shall conform to the Safety at Streetworks and Road Works ACOP 2013.
 - 4) All temporary traffic management signs should be located 450mm minimum from the kerb face.
 - 5) All temporary traffic management sign locations are indicative and are subject to on site approval from the supervisor.

College Hill.

Site Address: Mayfield Rd, Rotherfield, TN6 3JN
Client: south east water
Site Contact: Gary Kent
CPH Contact: Dartford office
Date of works: T.B.A
Date drawn: X
Drawn by: MB
Checked by:

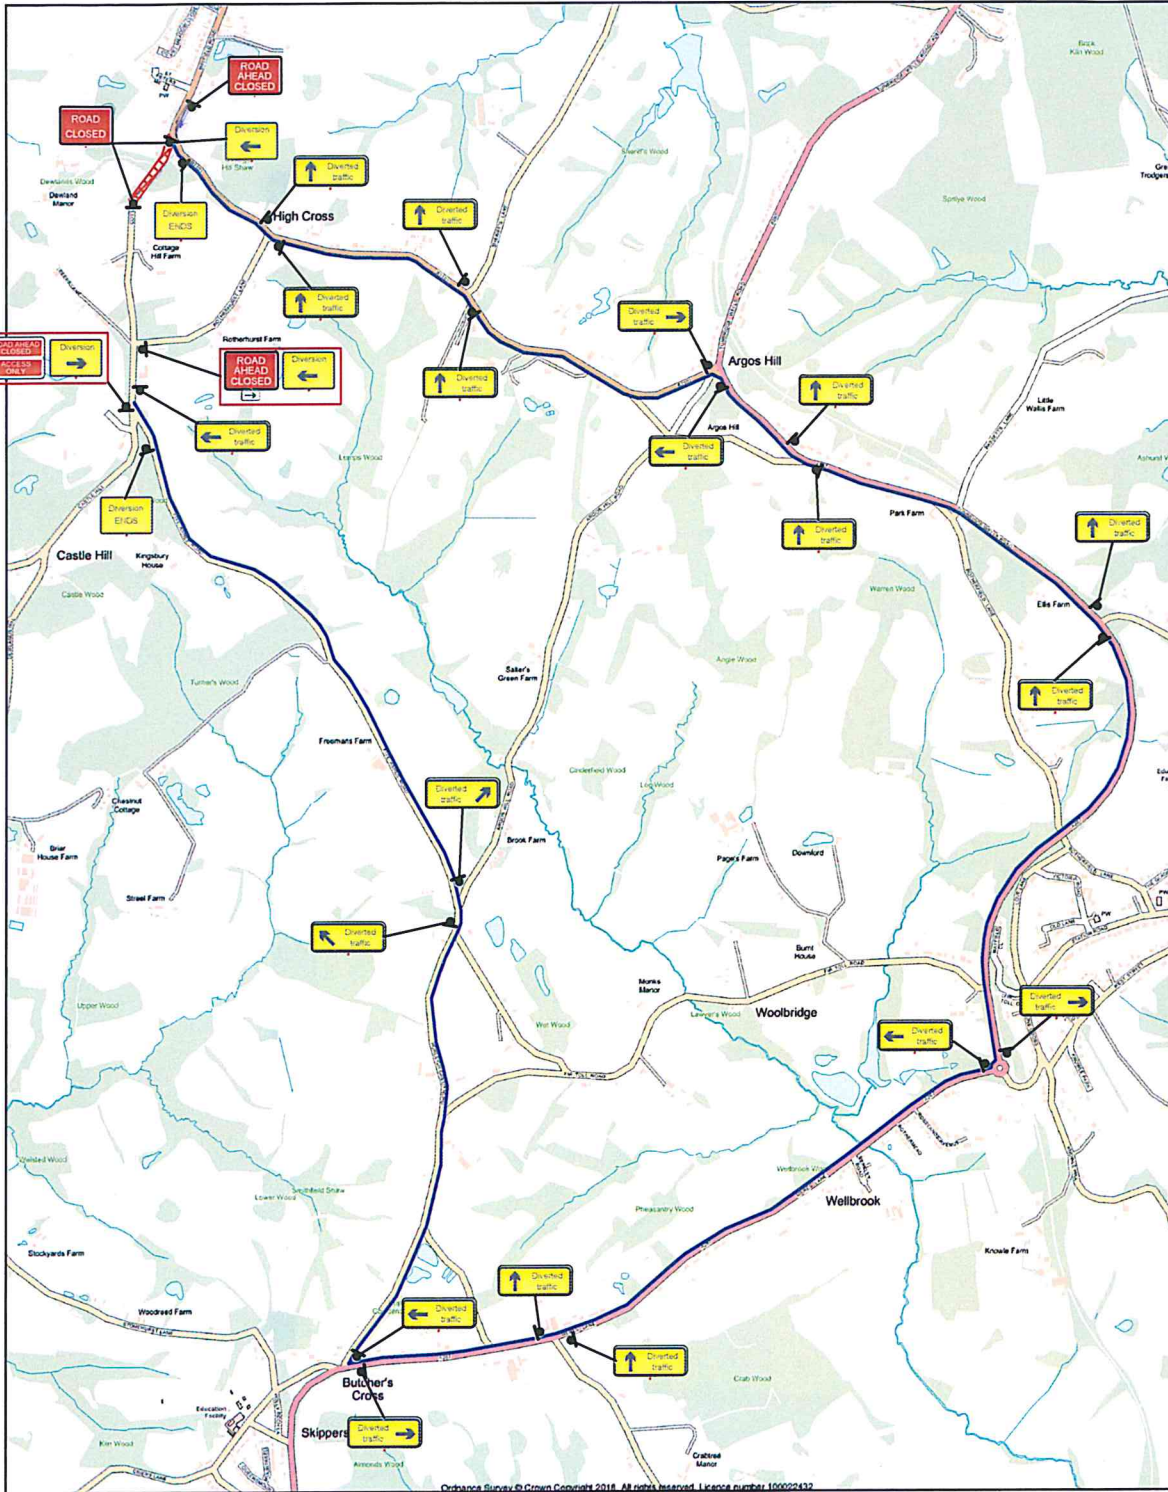

KEY


- Diversion Route
- 750 Road Cones
- Sign
- ⚡ Temporary Pedestrian Crossing
- ⚡ Temporary Traffic Signals
- ▨ Works Area
- ▨ Safety Zones
- Bus Stop To Be Suspended
- ⊕ Stop & Go
- 🚐 Van
- No Parking Cone
- ▨ Zebra Crossing
- 🚦 Signalised Junction and or Push Button Crossing
- Pedestrian Barrier

**PHASE 1
 ROAD CLOSURE / DIVERSION**

SET-UP TO BE IN ACCORDANCE WITH THE NRSWA SAFETY AT STREET WORKS CODE

Drawing number:
 WP-SE6045.MR423-DM516 MOD 1

Highcross

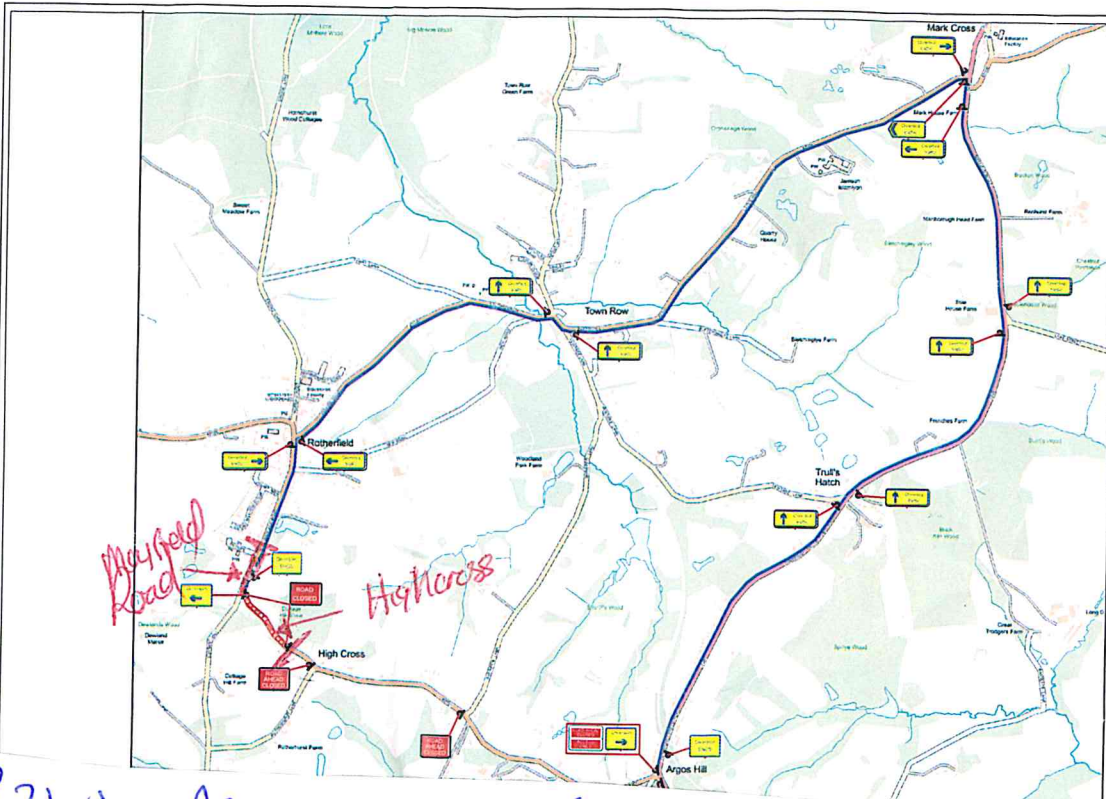

Site Address:
 Mayfield Road
 Rotherfield
 TN6 3JN

Site Contact: Gary Kent
 Client: south east water

CPH Contact:
 Ramsey Office

Date of works:
 T.B.A

Drawn by: MB
 Date drawn: 10/04/2018

Checked by:

KEY

- Diversion Route
- 750 Road Cones
- Sign
- Temporary Pedestrian Crossing
- Temporary Traffic Signals
- Works Area
- Safety Zone
- Bus Stop To Be Suspended
- Stop & Go
- Van
- No Parking Cone
- Zebra Crossing
- Signalised Junction and or Push Button Crossing
- Pedestrian Barrier

- ~~B2101 - Mayfield Rd~~
- ~~B2100 - Station Rd~~
- ~~B2100 - Cotts Hill~~
- ~~A207 - Mayfield Rd~~
- ~~A207 - Tlw Rd~~
- ~~A207 - Argos Hill~~
- ~~B2101 - Bicycle Arms Rd~~
- ~~B2101 - High cross~~

AFFIC DIVISION
 y Mill, Hawley Road
 rd, Kent, DA2 7SY
 ONE: 01322 394414
 FAX: 01322 290391

CTM
 CLANCY TRAFFIC
 MANAGEMENT

Initial green times			
Phase 1 10	Phase 2 10	Phase 3 10	Phase 4 10
Red times			
Phase 1 10	Phase 2 10	Phase 3 10	Phase 4 10

Drawing Number:
 WP-SE6045.MR423-DM517 MOD 1

Highcross.